




205 L Drum Lid

TOLERANCES
 UNLESS NOTED OTHERWISE
 PLEASE ALLOW BELOW TOLERANCES
 DIMENSIONS <200mm - ALLOW ± 5 mm
 DIMENSIONS 200 - 1000mm - ALLOW ± 10 mm
 DIMENSIONS >1000mm - ALLOW ± 15 mm

FMAM300.3306

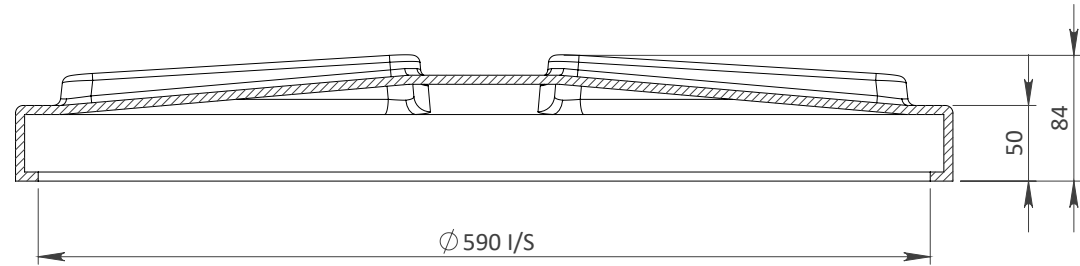

SECTION A-A
SCALE 1 : 5

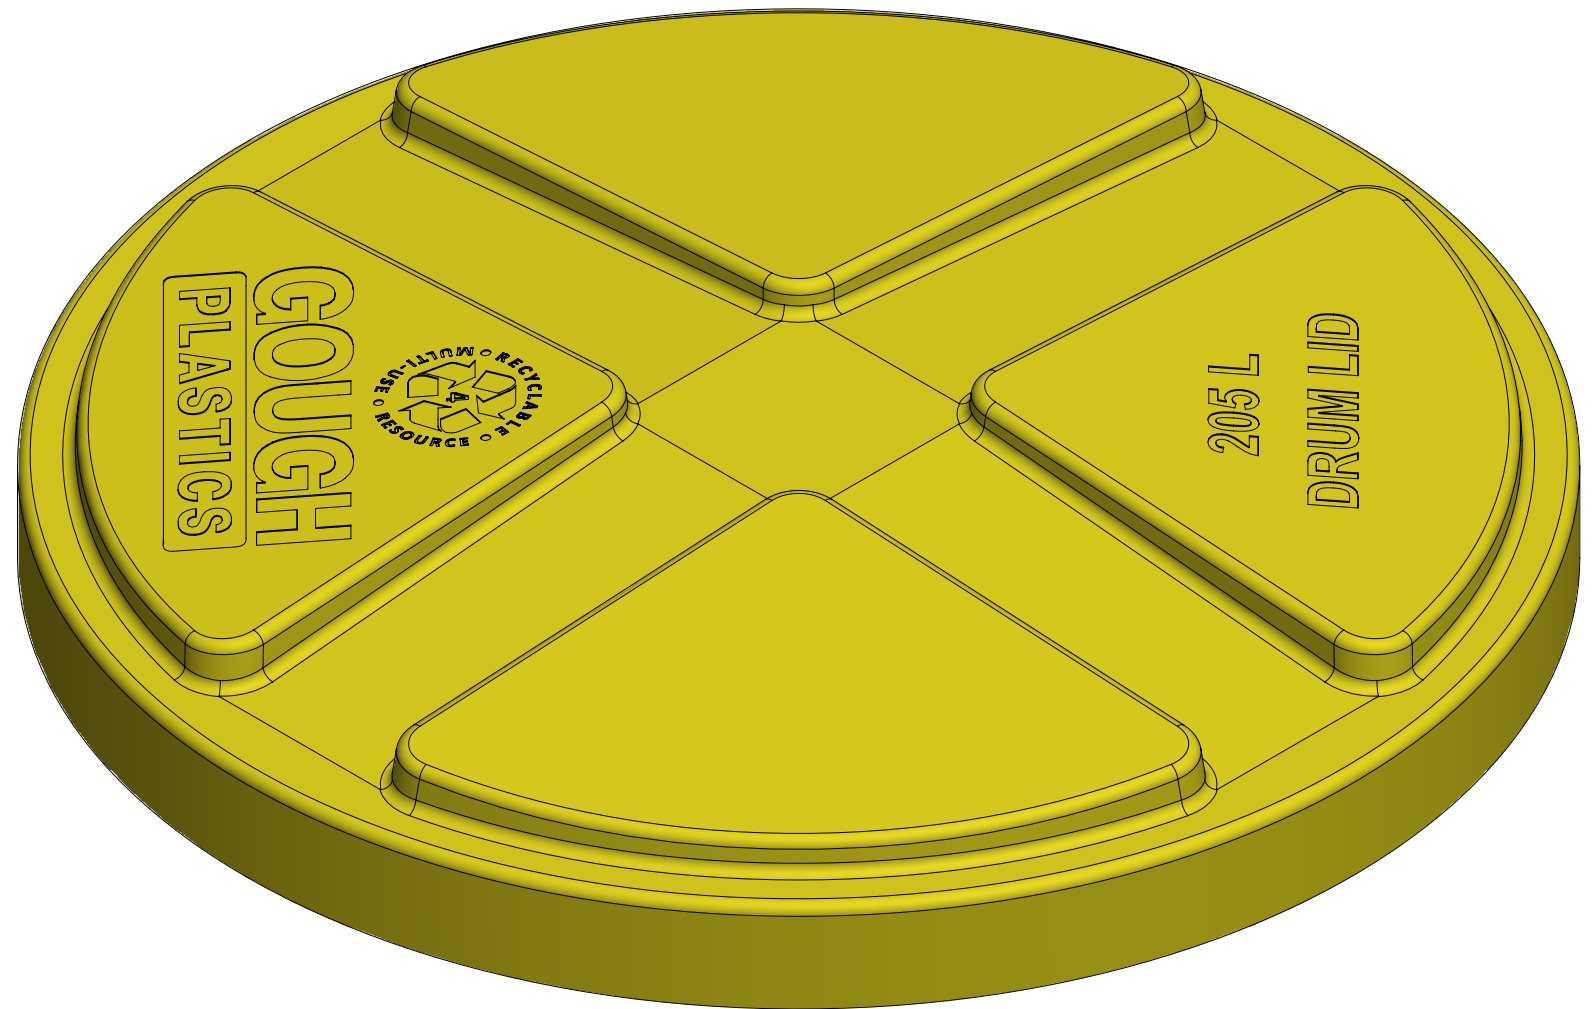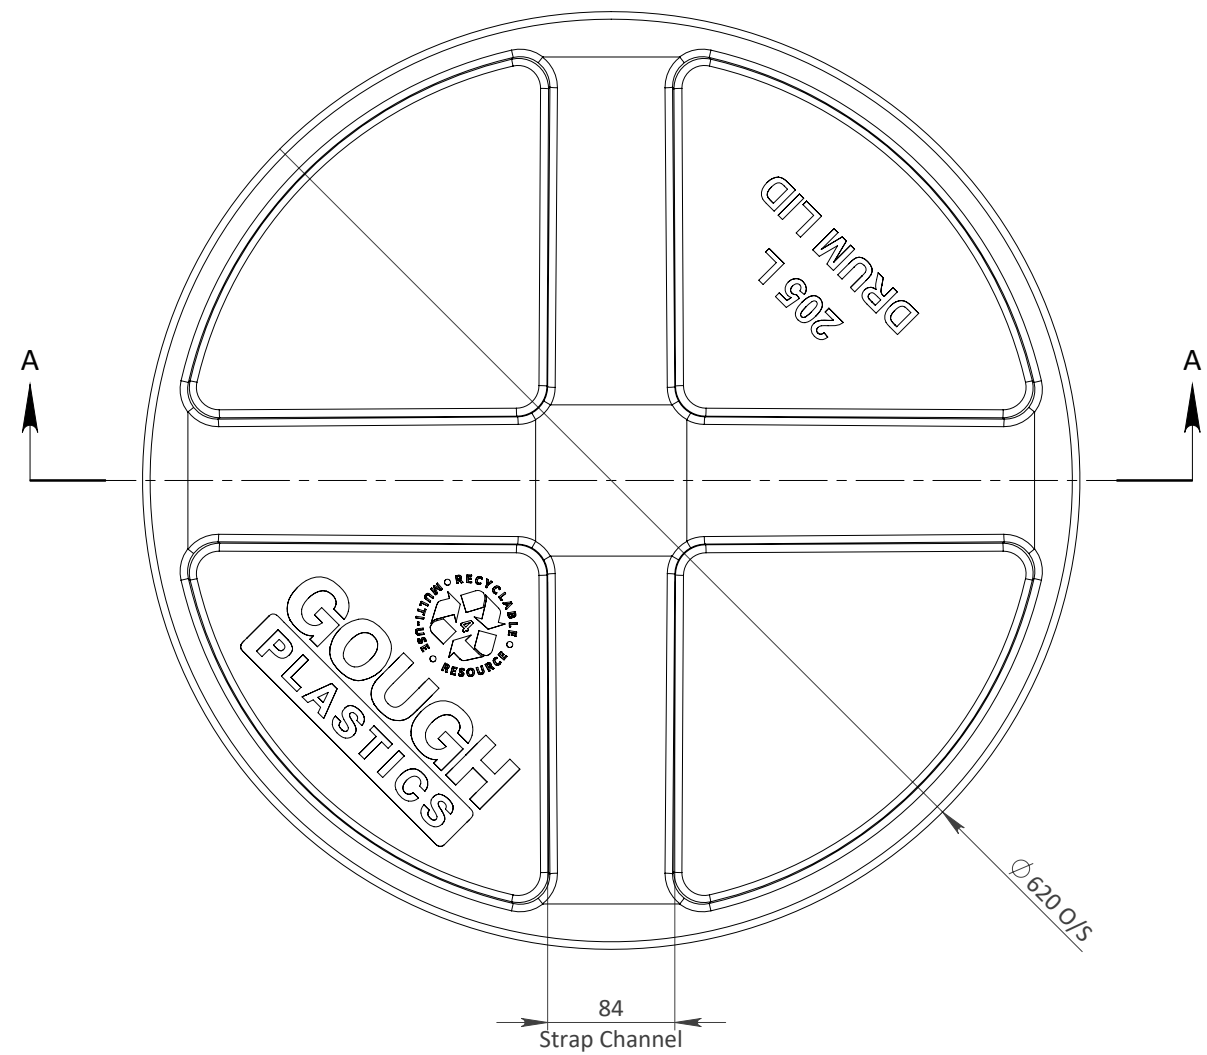

0	28/01/2021	AS BUILT	MC	DH	 <p>A.C.N. 010 028 547 Gough Industries Pty. Ltd. 833 Ingham Road Bohle, Townsville P.O. Box 7570, Garbutt BC, Qld. 4814. Telephone 07 47747606 www.gough.com.au</p>	CLIENT LOGO.	205 L Drum Lid		REVISION 0		
						SCALE	NTS	A3		GOUGH PLASTICS DRAWING No.	ENG-DRL-001
						SOLDWORKS: S:\Solidworks\Engineering\Material Handling\205L Drum Lid\205 L Drum Lid - 3					
						PDF. FILE PATH: S:\Products\Engineering\Marketing Engineering					
REV	DATE	REVISION DESCRIPTION	DRAWN	CHKD.	ENG.	Dimensions are in millimetres (mm) unless noted.					