





# GOUGH PLASTICS

## 5,000L WATER CARTAGE TANK + Skid

**TOLERANCES**  
NOTE: UNLESS NOTED OTHERWISE,  
PLEASE ALLOW DIMENSIONAL TOLERANCES  
DUE TO FABRICATION PROCESS AND  
POLYETHYLENE THERMAL EXPANSION  
DIMENSIONS <200mm - ALLOW ±3mm  
DIMENSIONS 200 - 1000mm - ALLOW ± 5mm  
DIMENSIONS >1000mm - ALLOW ± 10mm

MARK	PART	MATERIAL	PART CODE	DRAWING REF.
1	5,000L WATER CARTAGE TANK	BLUE WATER GRADE POLYETHYLENE	FFAR500.5051	RUR-WATER-5000
2	455mm HINGED LID - VENTED	BLACK POLYPROPYLENE	PARTAC.0203	
3	5,000L CARTAGE - STANDARD SKID	STEEL - HOT DIP GALVANISED	FFAR500.4051	FFAR500.4051
4	PIN MOUNTING SYSTEM	STEEL - HOT DIP GALVANISED	PARBKT0119	PARBKT0119

DRY WEIGHT: 415 KG APPROX.

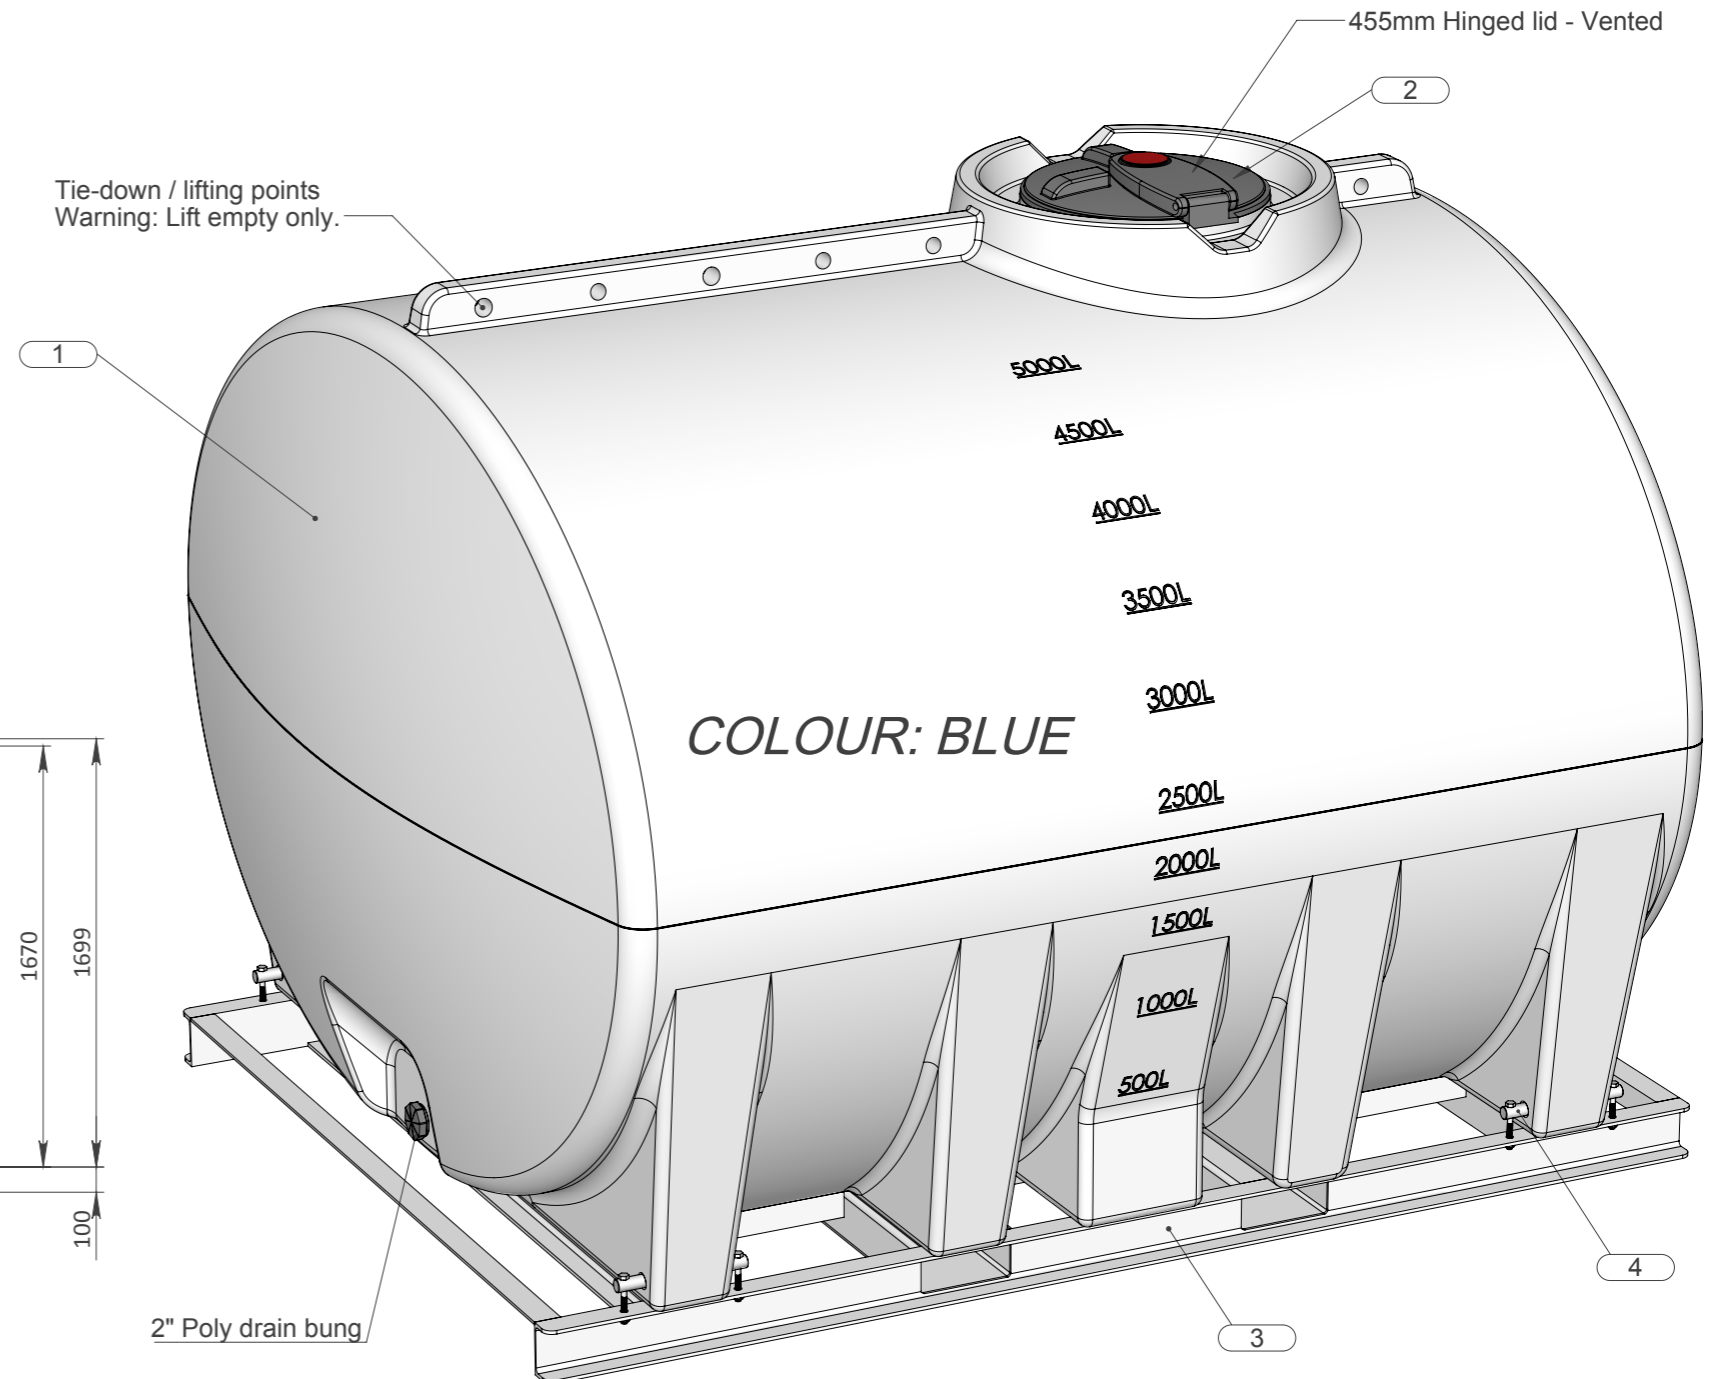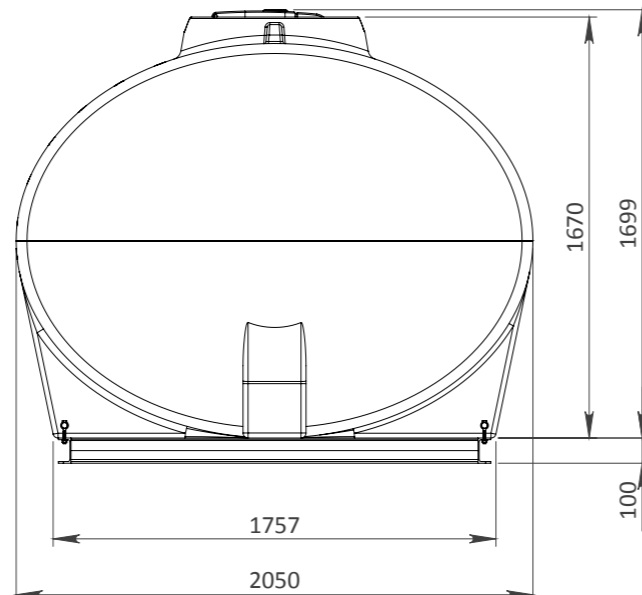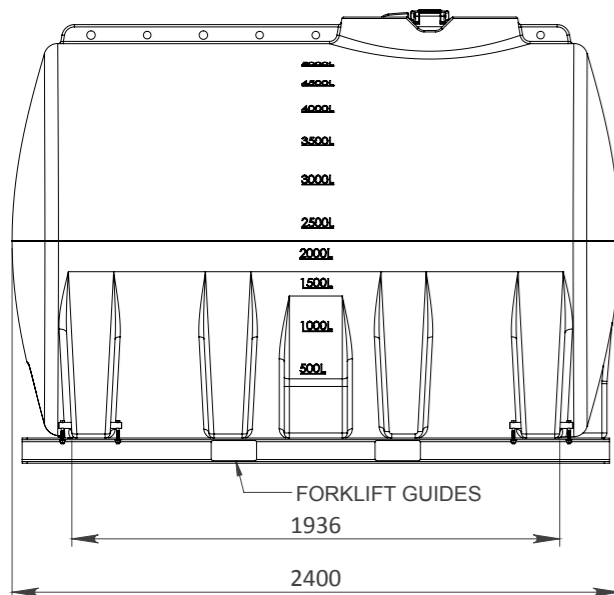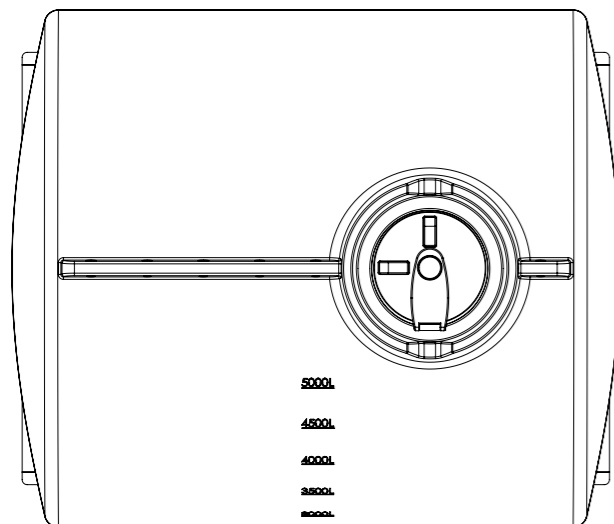

REV	DATE	REVISION DESCRIPTION	DRAWN	CHKD	LEAD ENG
A	17.10.18	AS BUILT	DH	JG	

**GOUGH  
PLASTICS**

A.C.N. 010 028 547  
Gough Industries Pty. Ltd.  
833 Ingham Road  
Bohle, Townsville  
P.O. Box 7570, Garbutt BC, Qld. 4814.  
Telephone 07 47747606  
Facsimile 07 47747608

CLIENT LOGO.

5,000L WATER CARTAGE TANK + SKID

SCALE  
NTS

A3

Gough Plastics Drg. No.  
**RUR-WATER-5000-S**

A

S:\Products\Rural\Cartage tanks