



## 50L WATER SLIMLINE Underbody


**TOLERANCES**  
 NOTE: UNLESS NOTED OTHERWISE,  
 PLEASE ALLOW DIMENSIONAL TOLERANCES  
 DUE TO FABRICATION PROCESS AND  
 POLYETHYLENE THERMAL EXPANSION  
 DIMENSIONS <200mm - ALLOW ±3mm  
 DIMENSIONS 200 - 1000mm - ALLOW ± 5mm  
 DIMENSIONS >1000mm - ALLOW ± 10mm

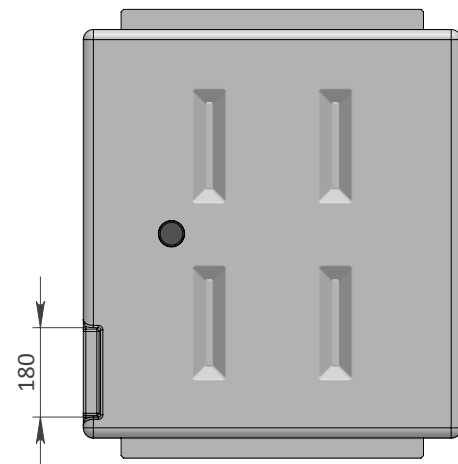

TOP VIEW

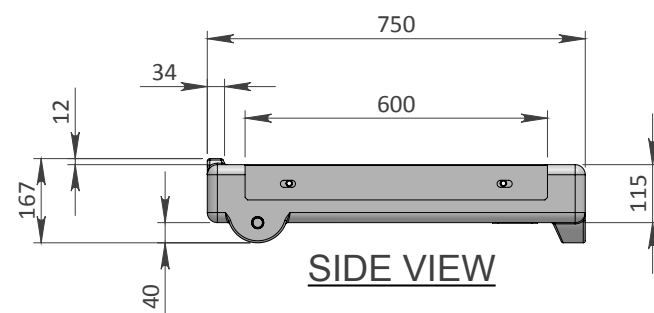


SIDE VIEW

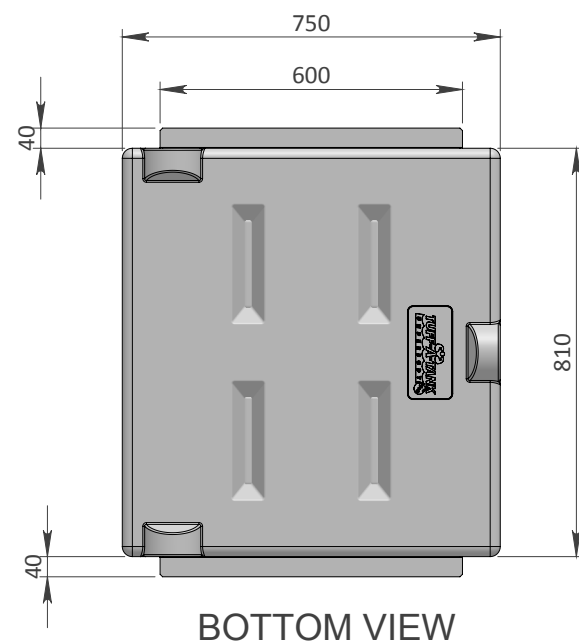


BOTTOM VIEW

MARK	PART	MATERIAL	QTY	PART CODE	DRAWING REF.
1	50L WATER SLIMLINE TANK	FOOD GRADE POLYETHYLENE	1	BOX405.8050	
2	50L MOUNTING BKT.	1.6mm GALVANISED SHEETMETAL	2	PARBKT0046	PARBKT0046
3	BRACKET BOLT	M10 x 25 HEX HD. ZP.	4	PARSCR0305	
4	SPRING WASHER	M10 x3.5x2.2 ZP.	4	PARSCR0504	
5	FLAT WASHER	M10 25 O.D x 2mm ZP.	4	PARSCR0503	
6	1" BRASS INSERT	BRASS	1	PARSCR4025	
7	2" BLACK GROMMET	P769	1	PARPLF1780	
8	1/2" POLY PLUG	POLY PLUG , HEX W/O-RING	2	PARPLF1721	
9	10mm THREADED INSERTS	BRASS	4	PARSCR0003	
10	1/2" THREADED INSERTS	BRASS	4	PARSCR3105	

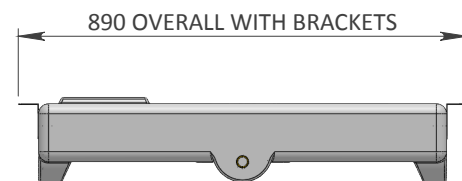

END VIEW

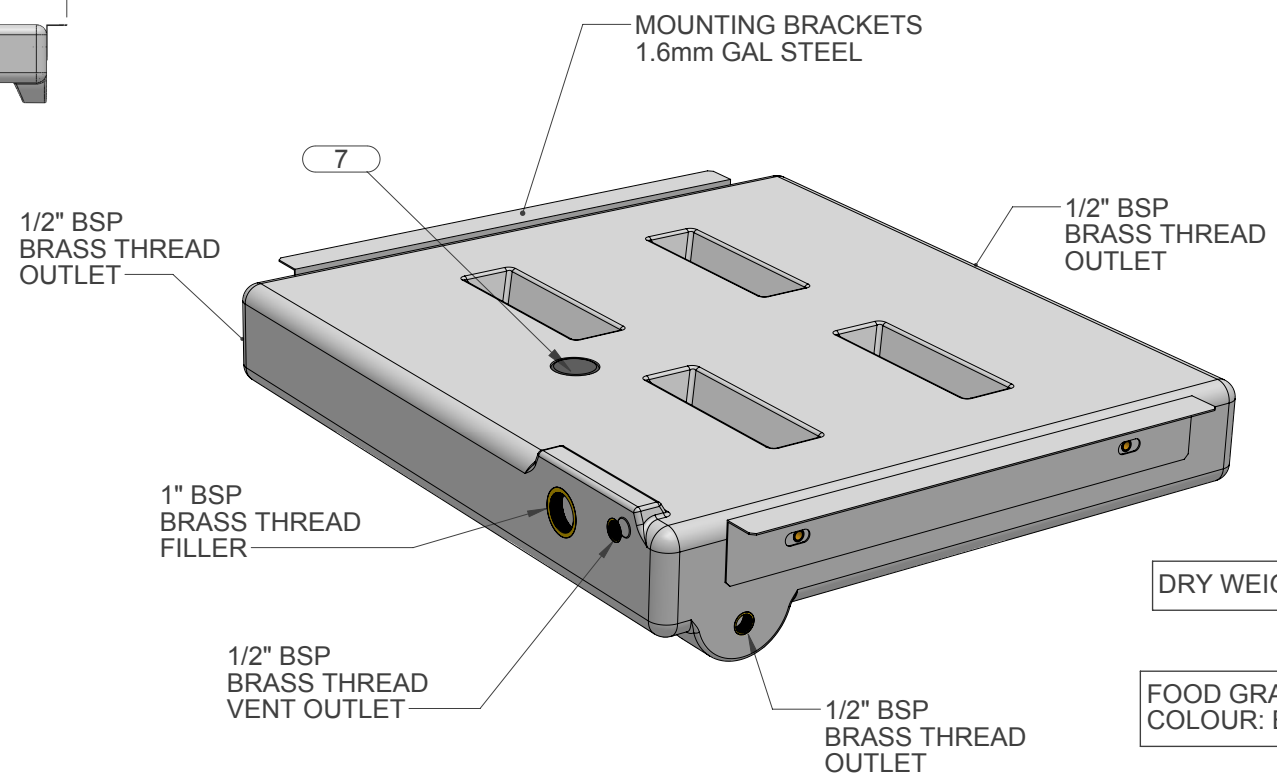

DRY WEIGHT: 12 KG APPROX.

FOOD GRADE POLYETHYLENE  
COLOUR: BLACK

Polyethylene material meets:  
 AS2070 - Plastic materials for food contact use  
 AS/NZS4020 - Testing of products for use in contact with drinking water

REV	DATE	REVISION DESCRIPTION	DRAWN	CHKD	LEAD ENG
A	16.10.18	AS BUILT	DH		

**GOUGH  
PLASTICS**

A.C.N. 010 028 547  
 Gough Industries Pty. Ltd.  
 833 Ingham Road  
 Bohle, Townsville  
 P.O. Box 7570, Garbutt BC, Qld. 4814.  
 Telephone 07 47747606  
 Facsimile 07 47747608

CLIENT LOGO.

50L UNDERBODY WATER SLIMLINE

SCALE  
NTS

A3

Gough Plastics Drg. No.

DOM-WATER-50-S

A  
REV

S:\Products\Domestice\Underbodies\PDF's