

NOTES:

AS BUILT

REV	DATE	REVISION DESCRIPTION	DRAWN	CHKD	LEAD ENG
2	09.01.17	AS BUILT	DH	IG	



A.C.N. 010 028 547  
 Gough Industries Pty. Ltd.  
 833 Ingham Road  
 Bohle, Townsville  
 P.O. Box 7570, Garbutt BC, Qld. 4814.  
 Telephone 07 47747606  
 Facsimile 07 47747608

CLIENT LOGO.

ECODOSE 400 - TANK

SCALE

1:10

A3

Gough Plastics Drg. No.



ENG-ECO400-001.04

2


REV

S:\Products\Engineering\Ecodose400\Sales&Marketing\Ecodose400 Product drawing


PLEASE NOTE:  
DIMENSIONS MAY VARY BY PLUS OR MINUS  
20mm DUE TO THE MOULDING PROCESS.

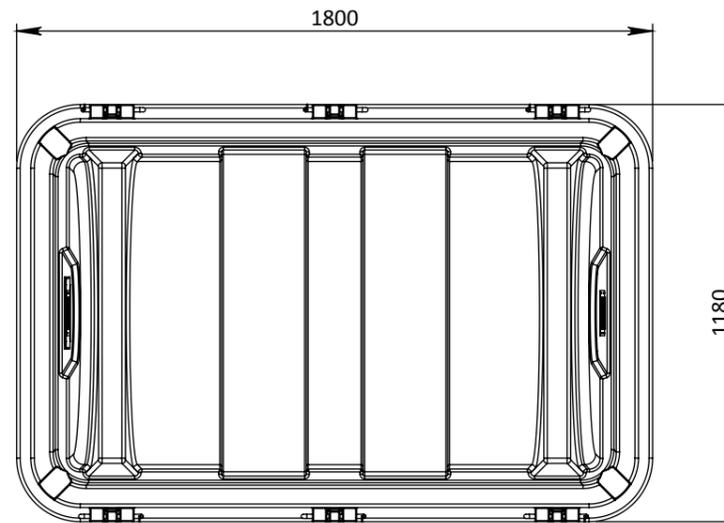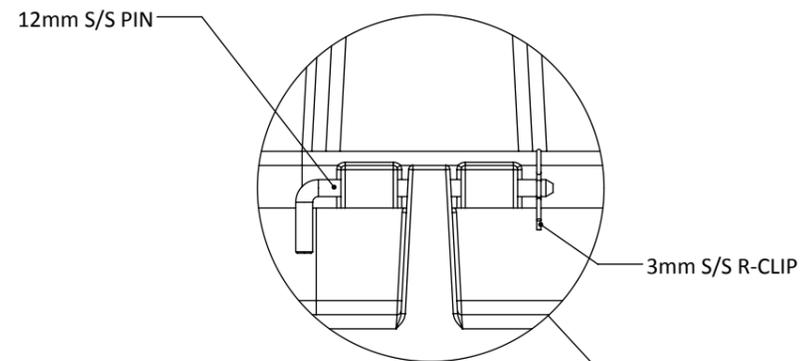


**TOP VIEW**

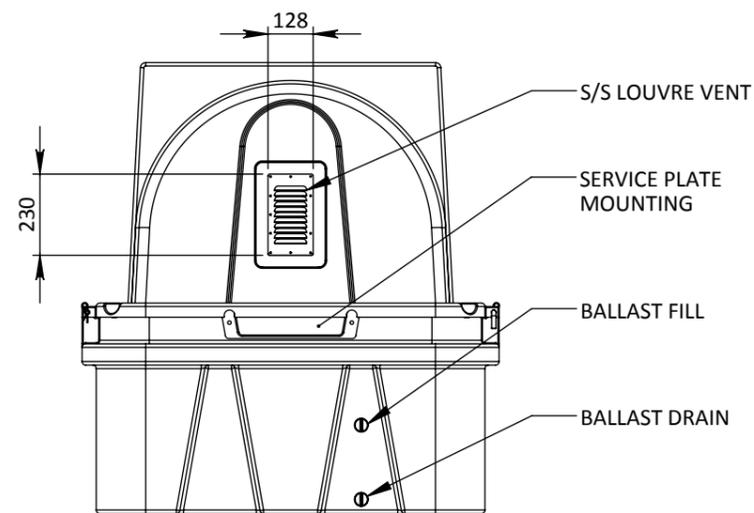

**FRONT VIEW**

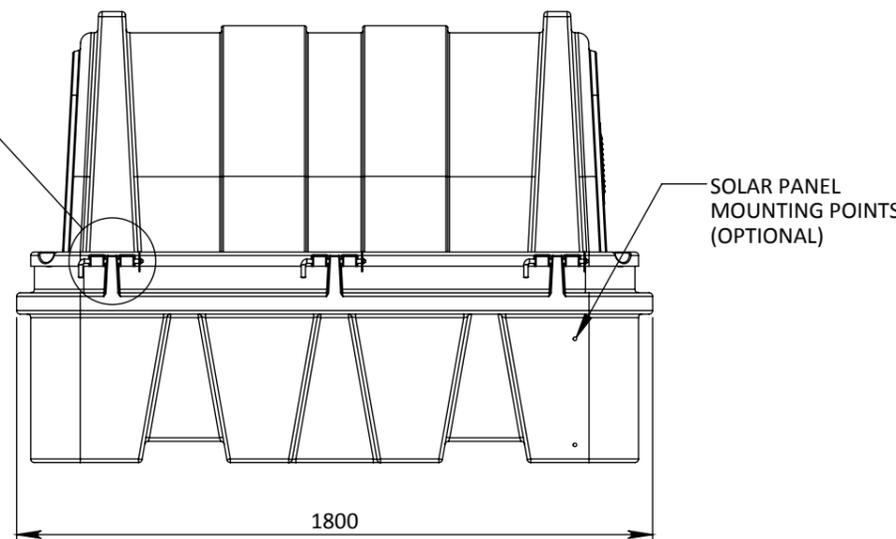

**SIDE VIEW**

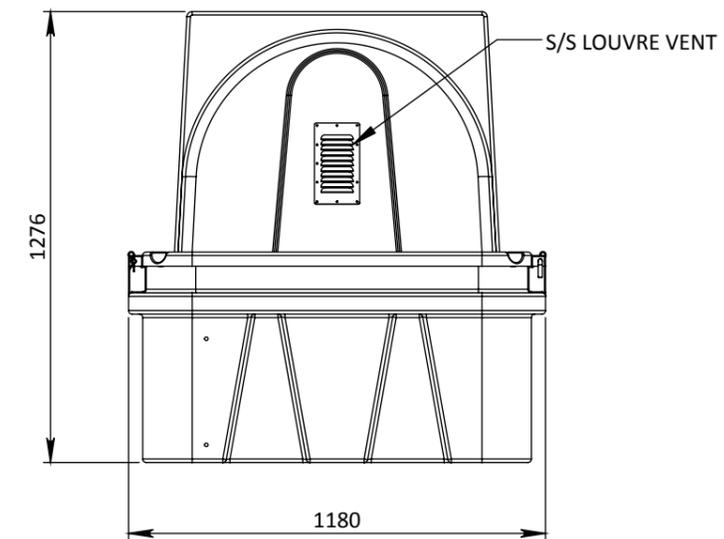

**REAR VIEW**

NOTES:  
MATERIAL: ROTATIONALLY MOULDED  
U.V STABILISED POLYETHYLENE  
(REFER SPEC SHEET)

AS BUILT

REV	DATE	REVISION DESCRIPTION	DRAWN	CHKD	LEAD ENG
2	09.01.17	AS BUILT	DH	IG	



A.C.N. 010 028 547  
Gough Industries Pty. Ltd.  
833 Ingham Road  
Bohle, Townsville  
P.O. Box 7570, Garbutt BC, Qld. 4814.  
Telephone 07 47747606  
Facsimile 07 47747608

CLIENT LOGO.

ECODOSE 400 - TANK

SCALE

1:10

A3

Gough Plastics Drg. No.


ENG-ECO400-001.04

2


REV

S:\Products\Engineering\Ecodose400\Sales&Marketing\Ecodose400 Product drawing


PLEASE NOTE:  
DIMENSIONS MAY VARY BY PLUS OR MINUS  
20mm DUE TO THE MOULDING PROCESS.

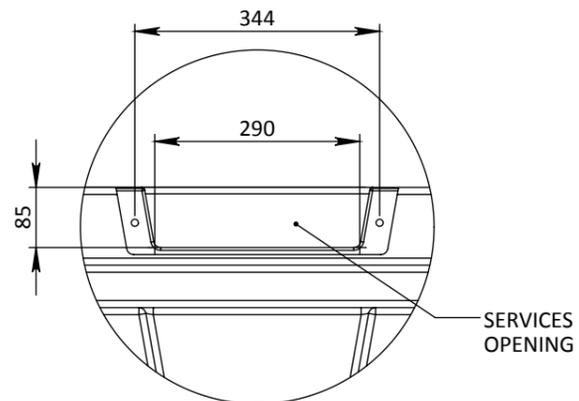


**FRONT VIEW**

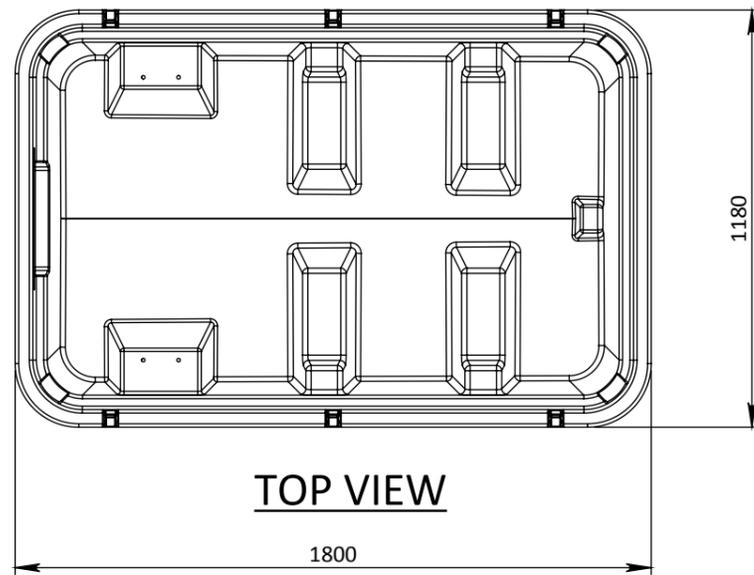



**TOP VIEW**

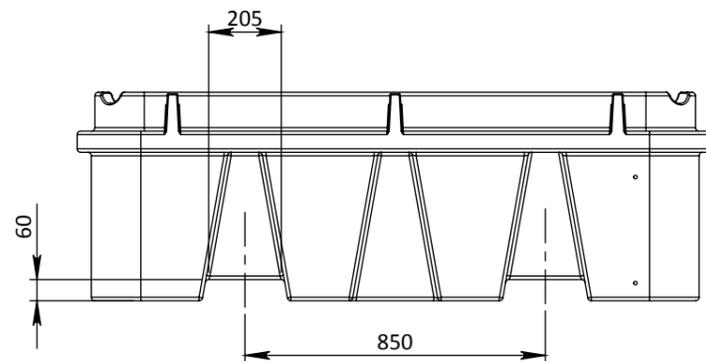


**SIDE VIEW**

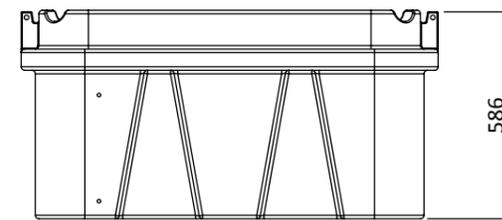

**REAR VIEW**

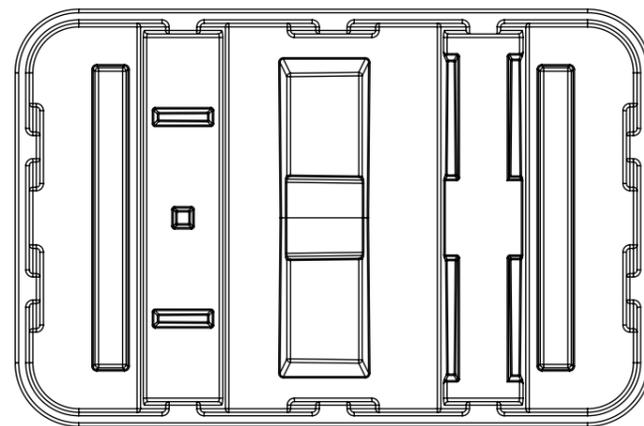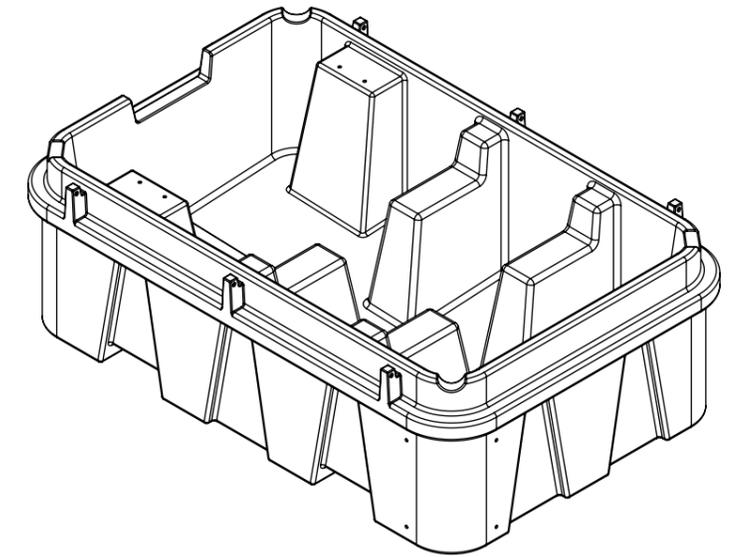

**BOTTOM VIEW**

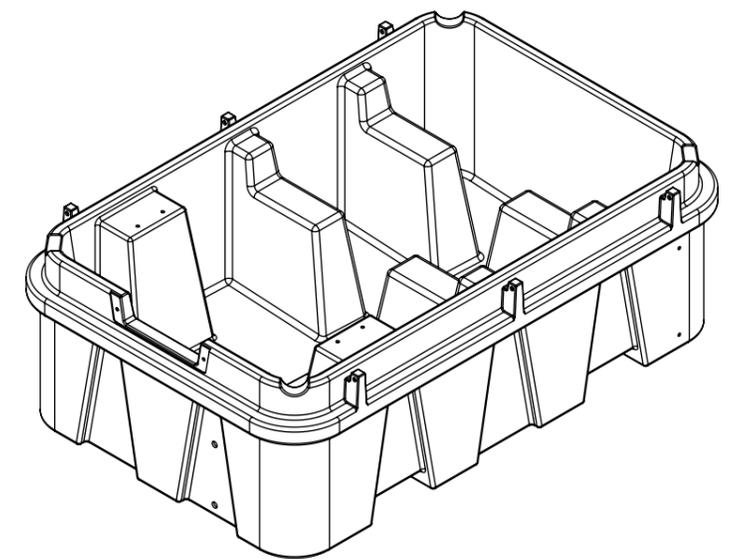

AS BUILT

NOTES:

REV	DATE	REVISION DESCRIPTION	DRAWN	CHKD	LEAD ENG
2	09.01.17	AS BUILT	DH	IG	



A.C.N. 010 028 547  
Gough Industries Pty. Ltd.  
833 Ingham Road  
Bohle, Townsville  
P.O. Box 7570, Garbutt BC, Qld. 4814.  
Telephone 07 47747606  
Facsimile 07 47747608

CLIENT LOGO.

ECODOSE 400 - TANK

SCALE

1:10

A3

Gough Plastics Drg. No.




ENG-ECO400-001.04

2




REV

S:\Products\Engineering\Ecodose400\Sales&Marketing\Ecodose400 Product drawing

PLEASE NOTE:  
DIMENSIONS MAY VARY BY PLUS OR MINUS  
20mm DUE TO THE MOULDING PROCESS.

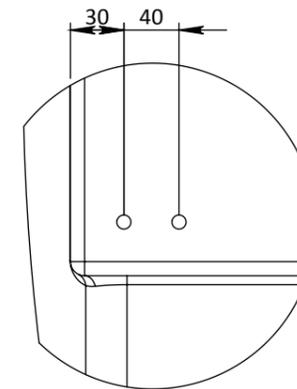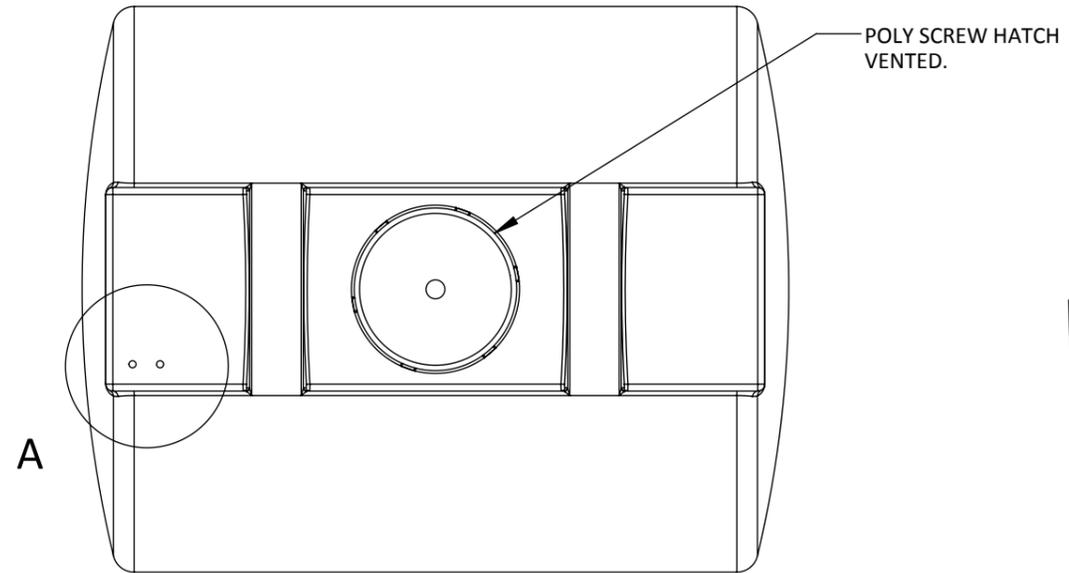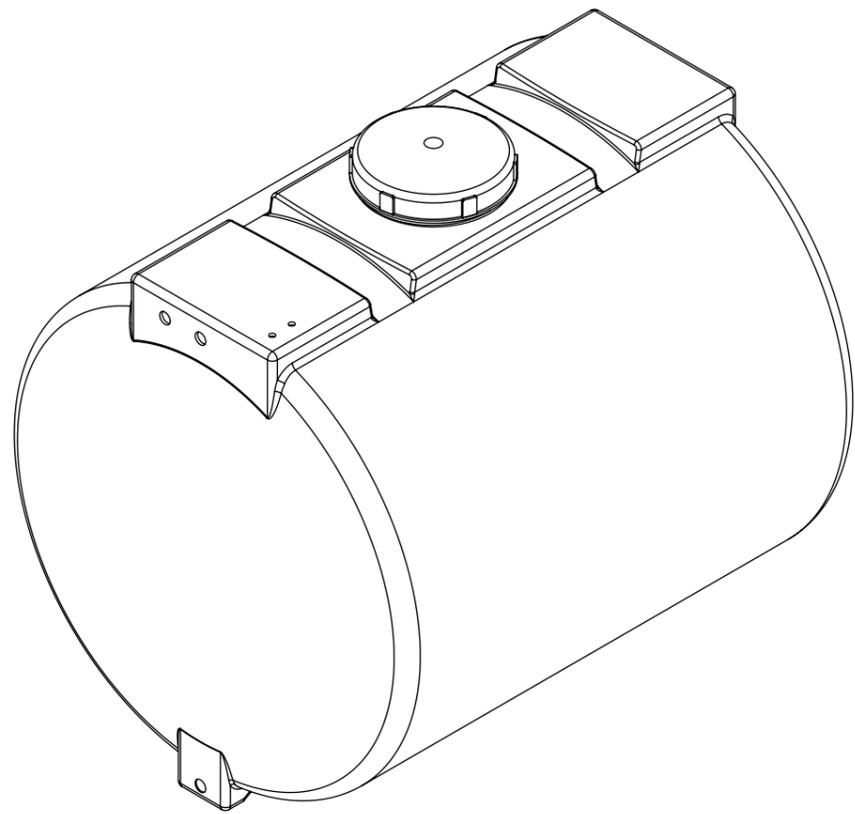

DETAIL A  
SCALE 1 : 5

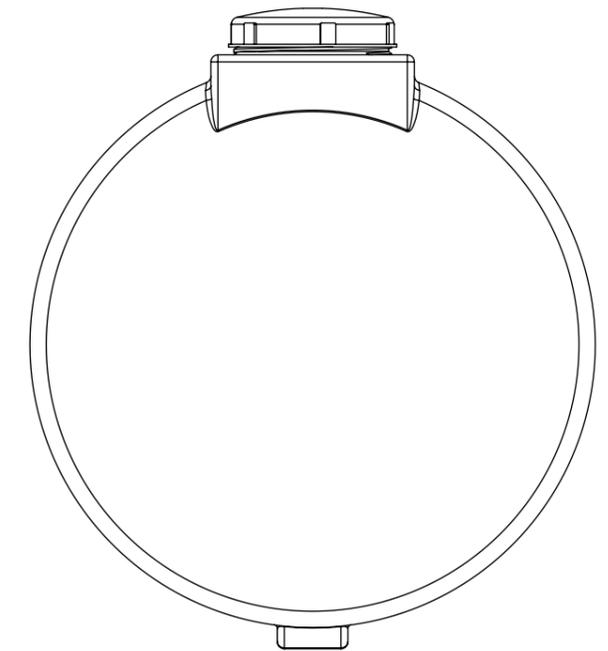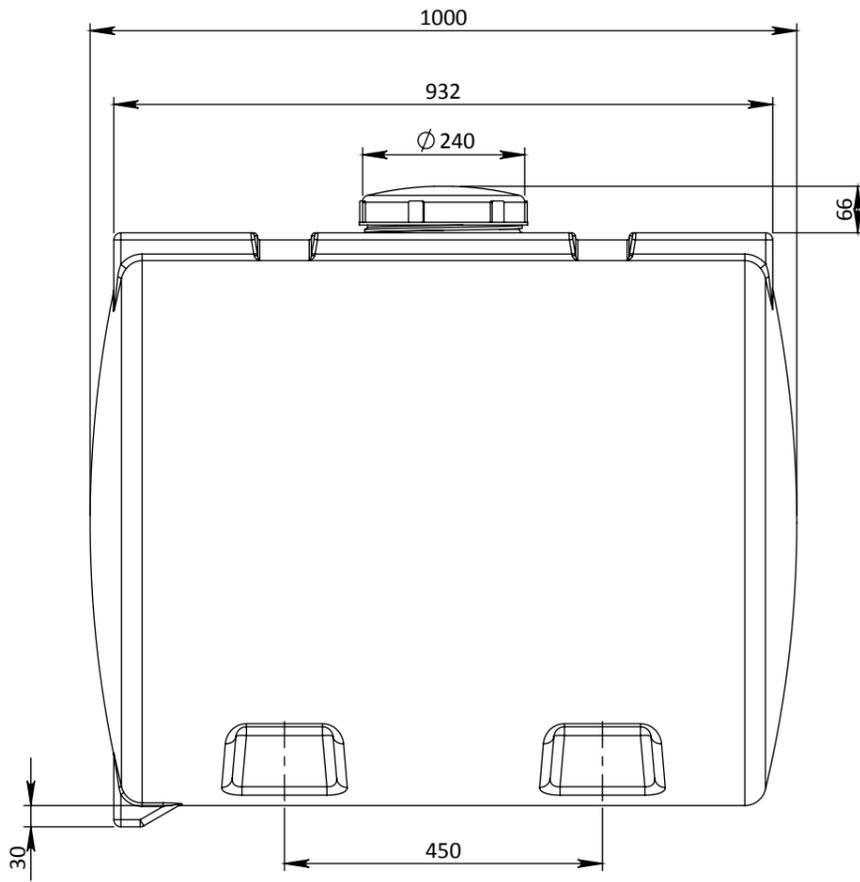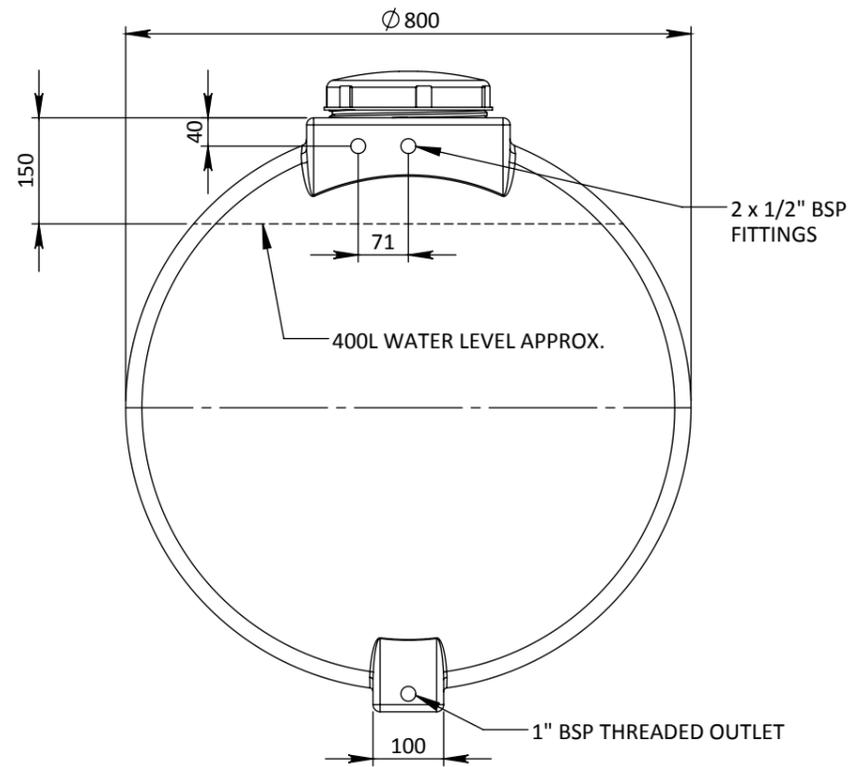

NOTES:

AS BUILT

REV	DATE	REVISION DESCRIPTION	DRAWN	CHKD	LEAD ENG
2	09.01.17	AS BUILT	DH	IG	



A.C.N. 010 028 547  
Gough Industries Pty. Ltd.  
833 Ingham Road  
Bohle, Townsville  
P.O. Box 7570, Garbutt BC, Qld. 4814.  
Telephone 07 47747606  
Facsimile 07 47747608

CLIENT LOGO.  
  
S:\Products\Engineering\Ecodose400\Sales&Marketing\Ecodose400 Product drawing

ECODOSE 400 - TANK			
SCALE 1:10	A3	Gough Plastics Drg. No. ENG-ECO400-001.04	2
			REV