
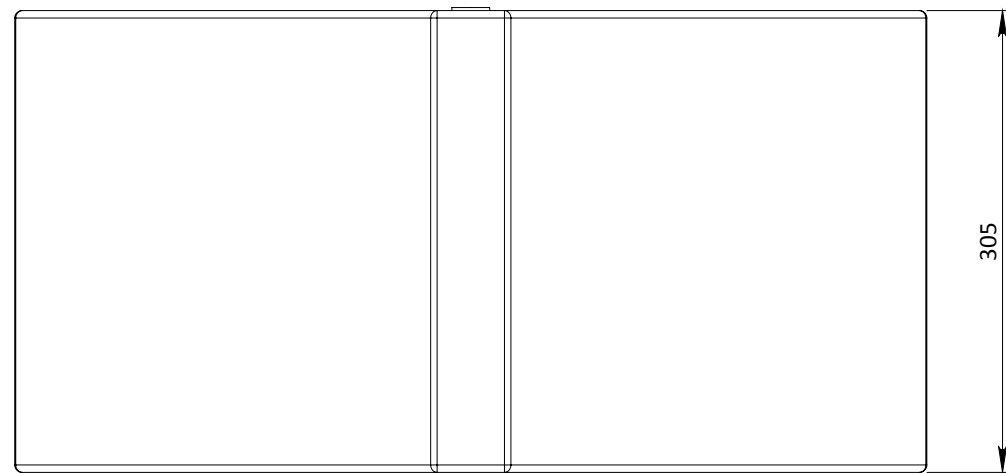
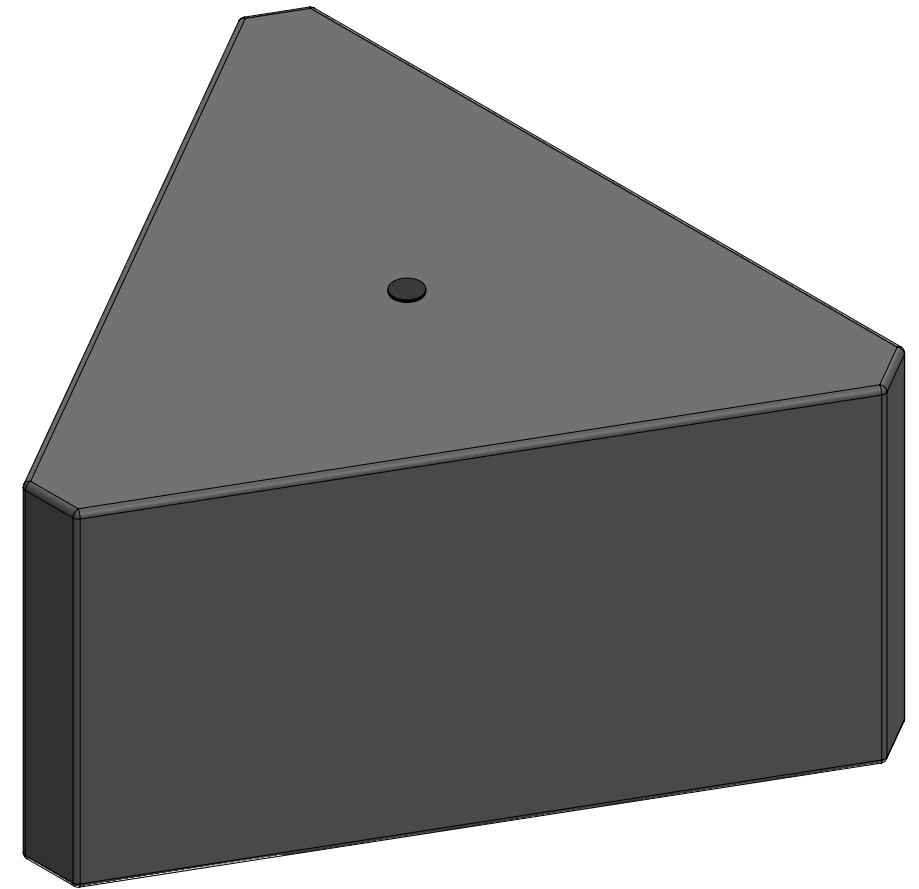


TRIANGULAR PRISM

TOLERANCES
 UNLESS NOTED OTHERWISE
 PLEASE ALLOW BELOW TOLERANCES
 DIMENSIONS <200mm - ALLOW ± 3mm
 DIMENSIONS 200 - 1000mm - ALLOW ± 5mm
 DIMENSIONS >1000mm - ALLOW ± 10mm

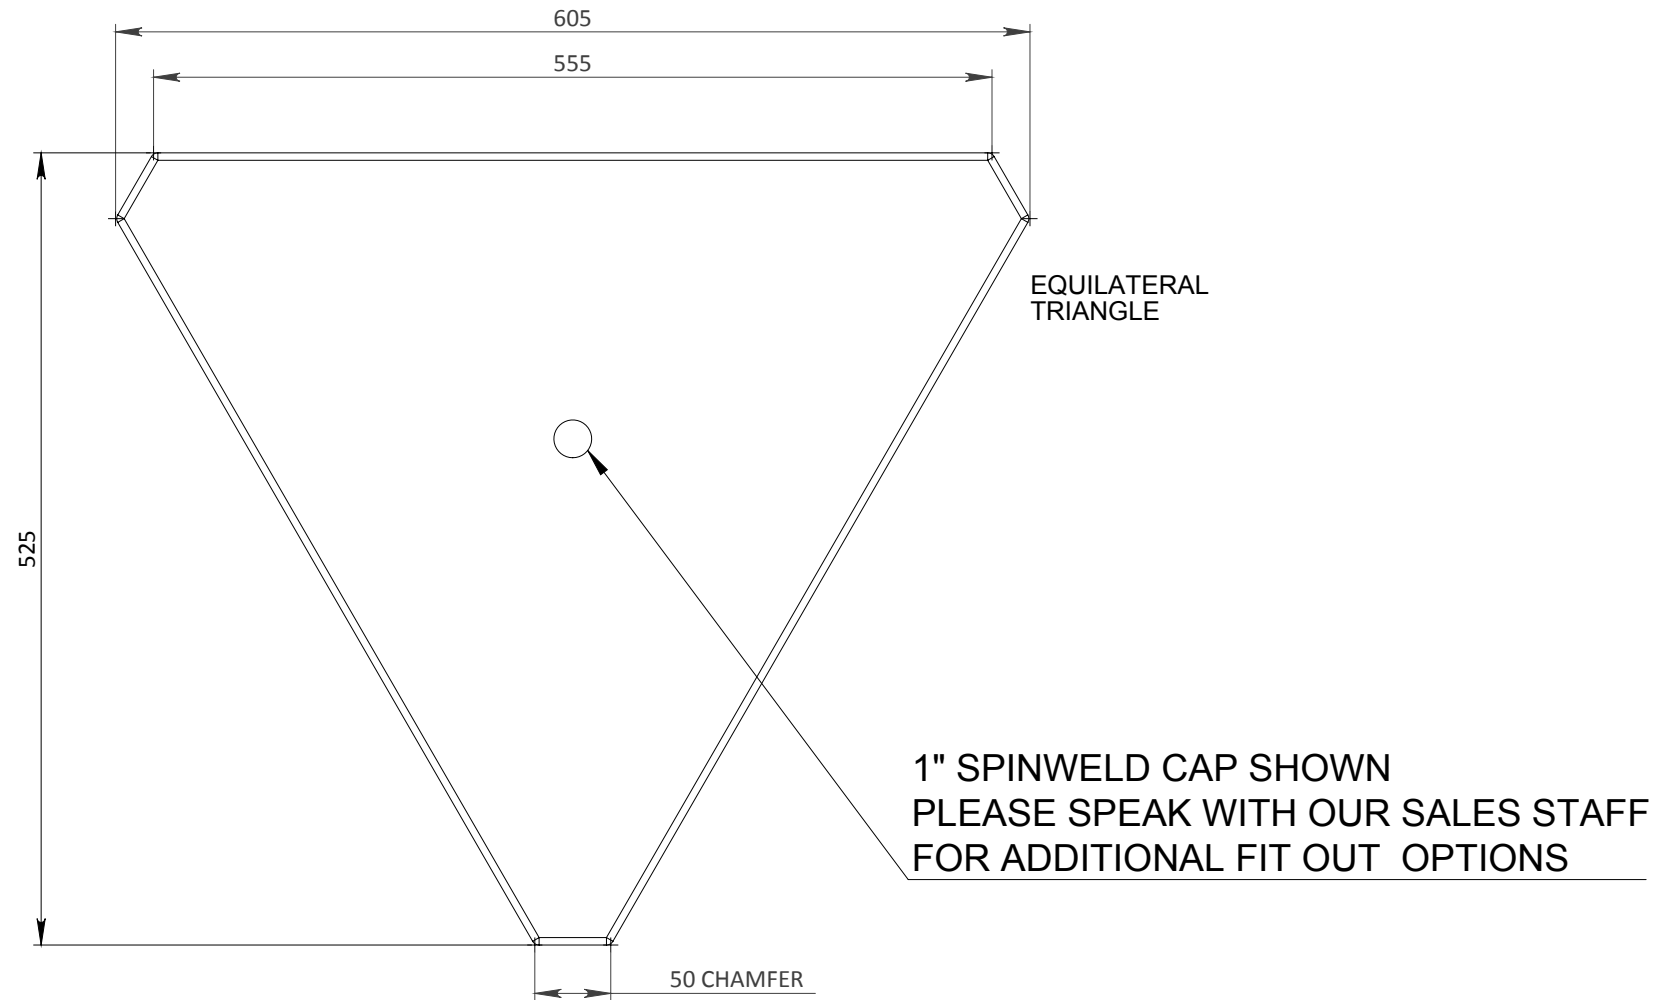

A	1/06/2020	AS BUILT	MC	DH		 <p>A.C.N. 010 028 547 Gough Industries Pty. Ltd. 833 Ingham Road Bohle, Townsville P.O. Box 7570, Garbutt BC, Qld. 4814. Telephone 07 47747606 www.gough.com.au</p>	CLIENT LOGO.	ENG-TRI-001				
							SCALE	NTS	A3	GOUGH PLASTICS DRAWING No.	ENG-TRI-001	REVISION
								SOLDWORKS: S:\Solidworks\Engineering\Material Handling\Triangular Prism\Triangular Prism				
								PDF. FILE PATH: S:\Products\Engineering\Marketing Engineering				
REV	DATE	REVISION DESCRIPTION	DRAWN	CHKD.	ENG.	Dimensions are in millimetres (mm) unless noted.						