





ROTATIONALLY MOULDED DUMP POINT  
MATERIAL: LLDPE LINEAR LOW DENSITY  
POLYETHYLENE.

PRODUCT WEIGHT: 33 kg Approx.

# DUMP-EZY - DUMPSTATION

## Product Drawing

**TOLERANCES**  
UNLESS NOTED OTHERWISE  
PLEASE ALLOW BELOW TOLERANCES  
DIMENSIONS <200mm - ALLOW ±3mm  
DIMENSIONS 200 - 1000mm - ALLOW ± 5mm  
DIMENSIONS >1000mm - ALLOW ± 10mm

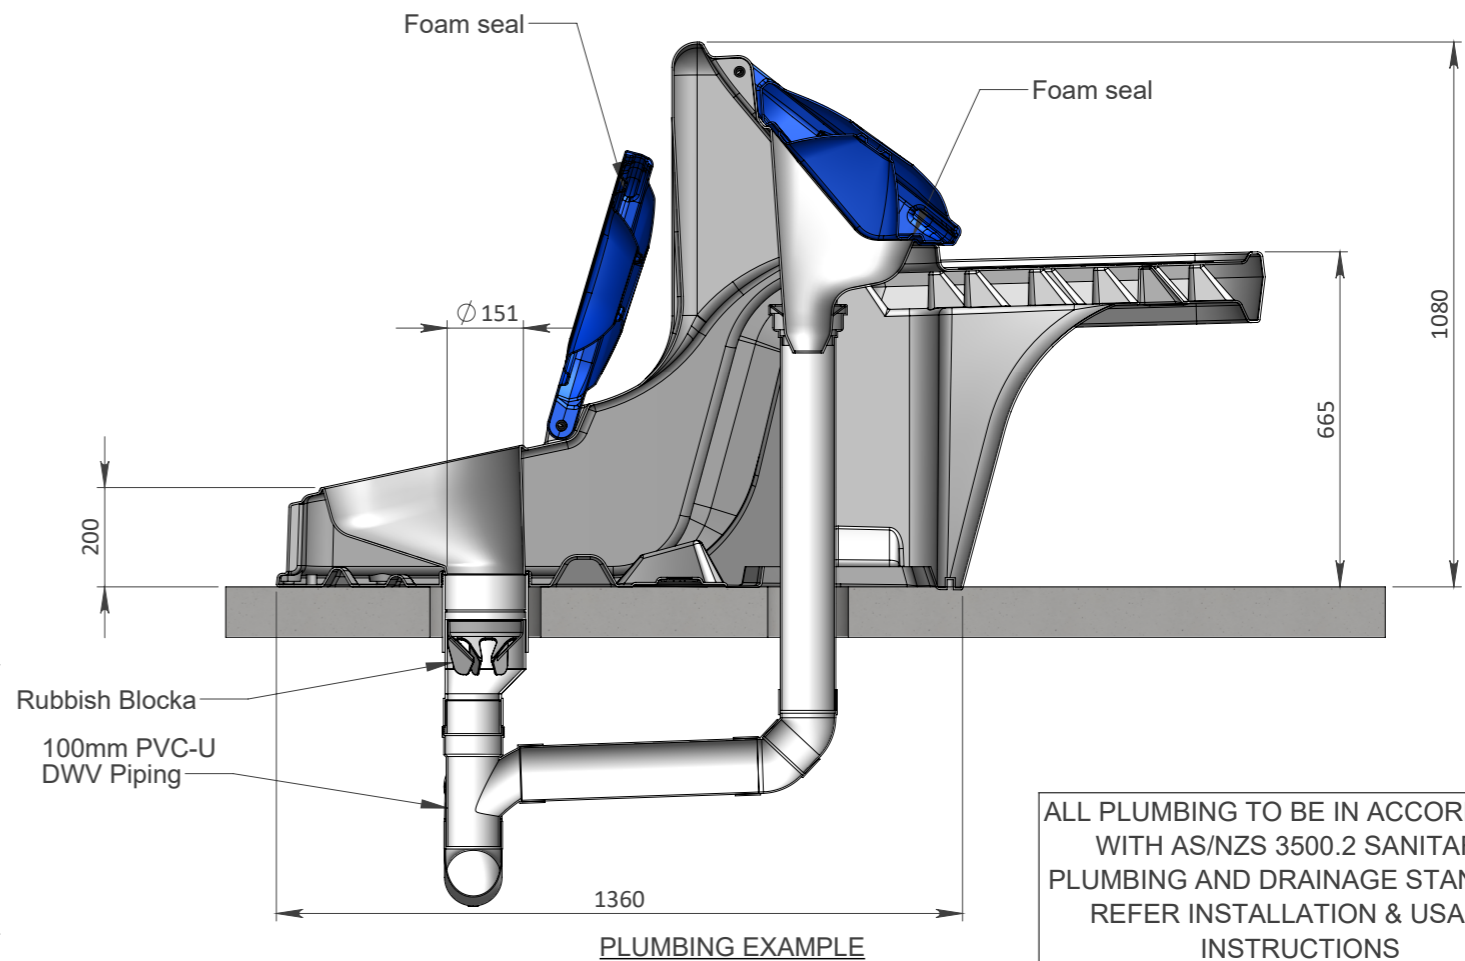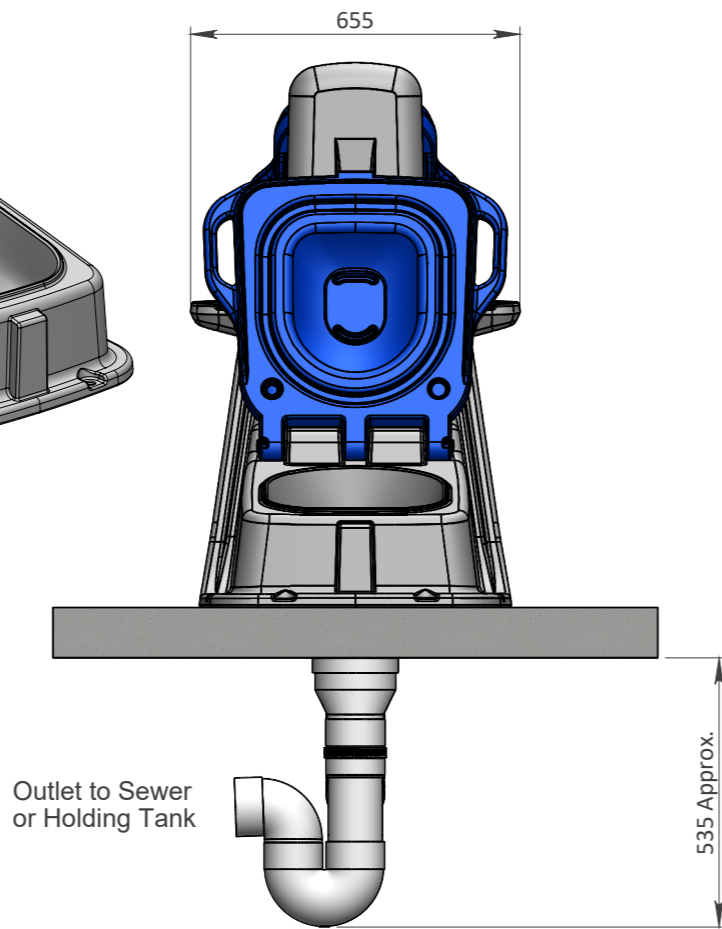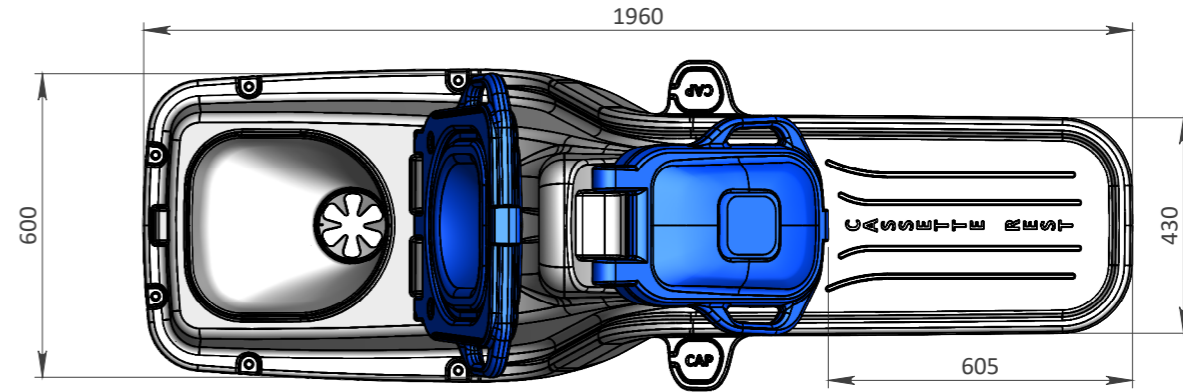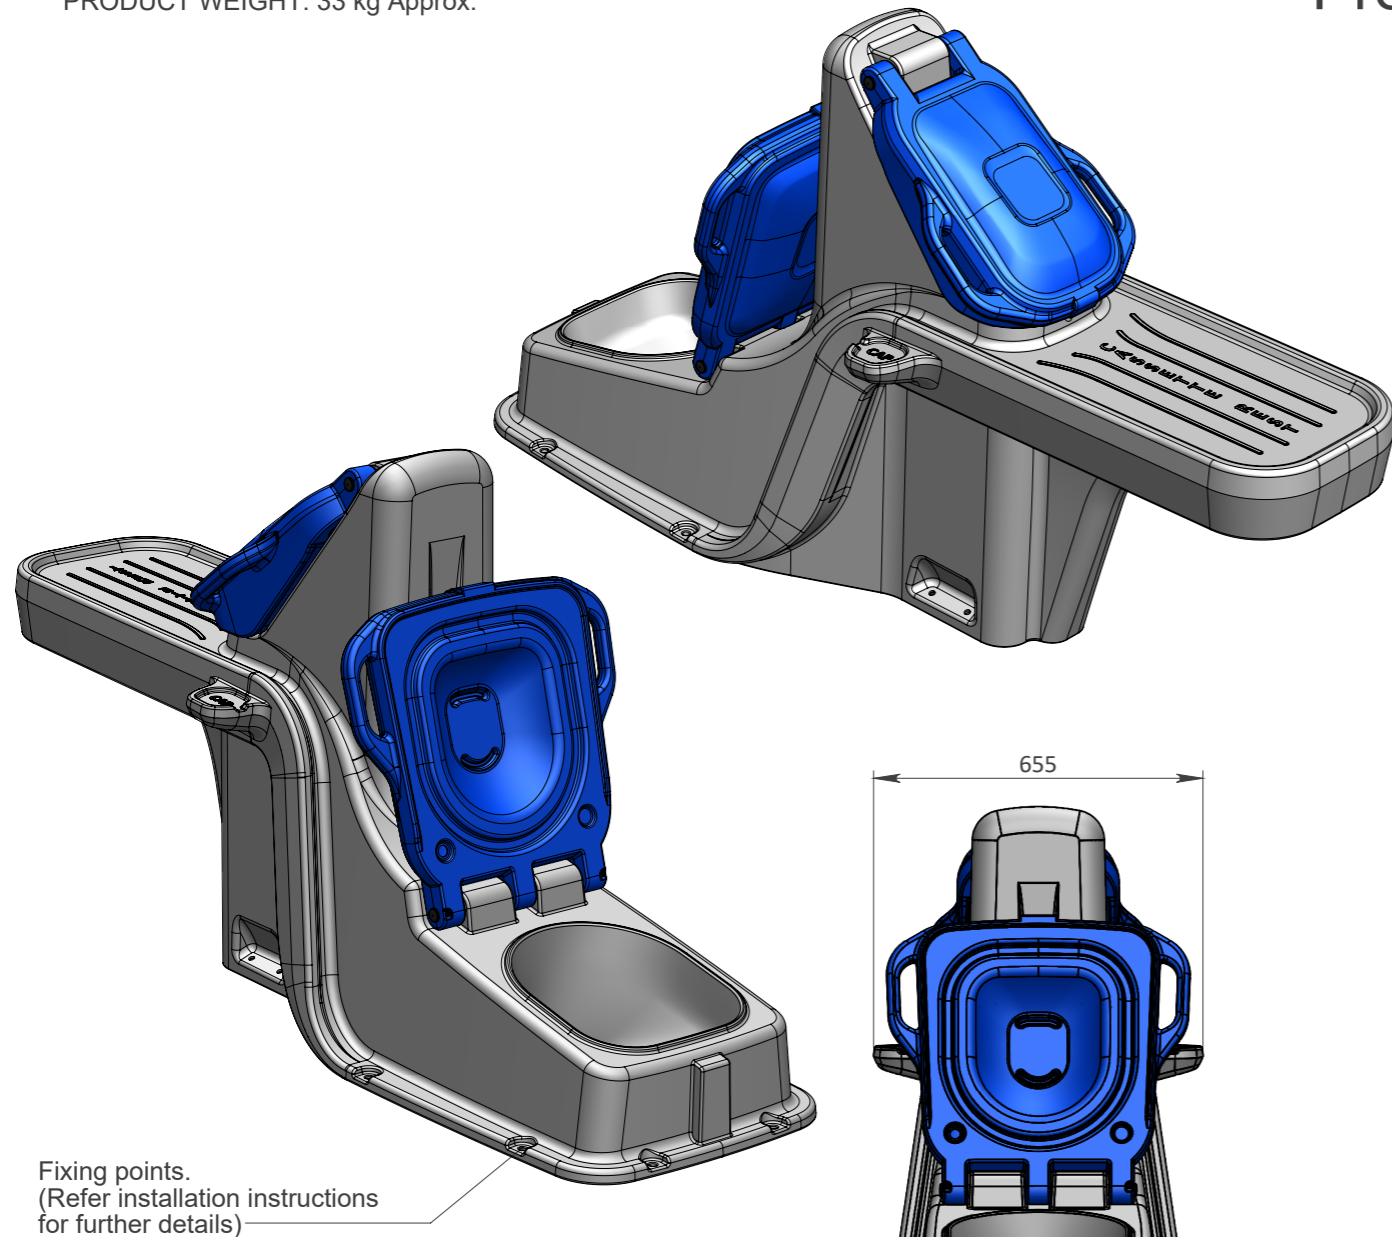

ALL PLUMBING TO BE IN ACCORDANCE  
WITH AS/NZS 3500.2 SANITARY  
PLUMBING AND DRAINAGE STANDARD  
REFER INSTALLATION & USAGE  
INSTRUCTIONS  
FOR FURTHER DETAIL

AS BUILT

REGISTERED DESIGN NUMBER : 202116495

REV	DATE	REVISION DESCRIPTION	DRAWN	CHKD.	ENG.
A	16.09.20	ISSUED FOR REVIEW	DH	SG	
0	30.11.21	AS BUILT	DH	SG	

**GOUGH  
PLASTICS**

A.C.N. 010 028 547  
Gough Industries Pty. Ltd.  
833 Ingham Road  
Bohle, Townsville  
P.O. Box 7570, Garbutt BC, Qld. 4814.  
Telephone 07 47747606  
www.gough.com.au

CONTROLLED DOCUMENT

Dimensions are in  
millimetres (mm)  
unless noted.

SOLDWORKS: S:\Solidworks\Environmental\Dumpezy\DUMP-EZY DUMP STATION\Dumpezy Dump Station Plumbing Assembly

PDF FILE PATH: S:\Products\Environmental\Marketing Environmental\Dump Station

DUMPEZY - DUMPSTATION - PRODUCT DRAWING

SCALE  
NTS A3

GOUGH PLASTICS DRAWING No.

FENV906.0000

REVISION  
0