


50mm Flex Connection Kit

FTAN204.0058

ITEM	DESCRIPTION	PART No.	QTY.
1	50mm Nipple - PP	PARPLF1352	1
2	50mm Ball Valve - NPB	PARTAC1050	1
3	50mm Hose Tail - PP	PARTAC1055	2
4	Hose Clamp 56-59 mm - SS	PARTAC1070	2
5	50mm Flex Hose - PVC	PARTAC1065	1
6	Thread Tape - PTFE	CONPAC0008	1

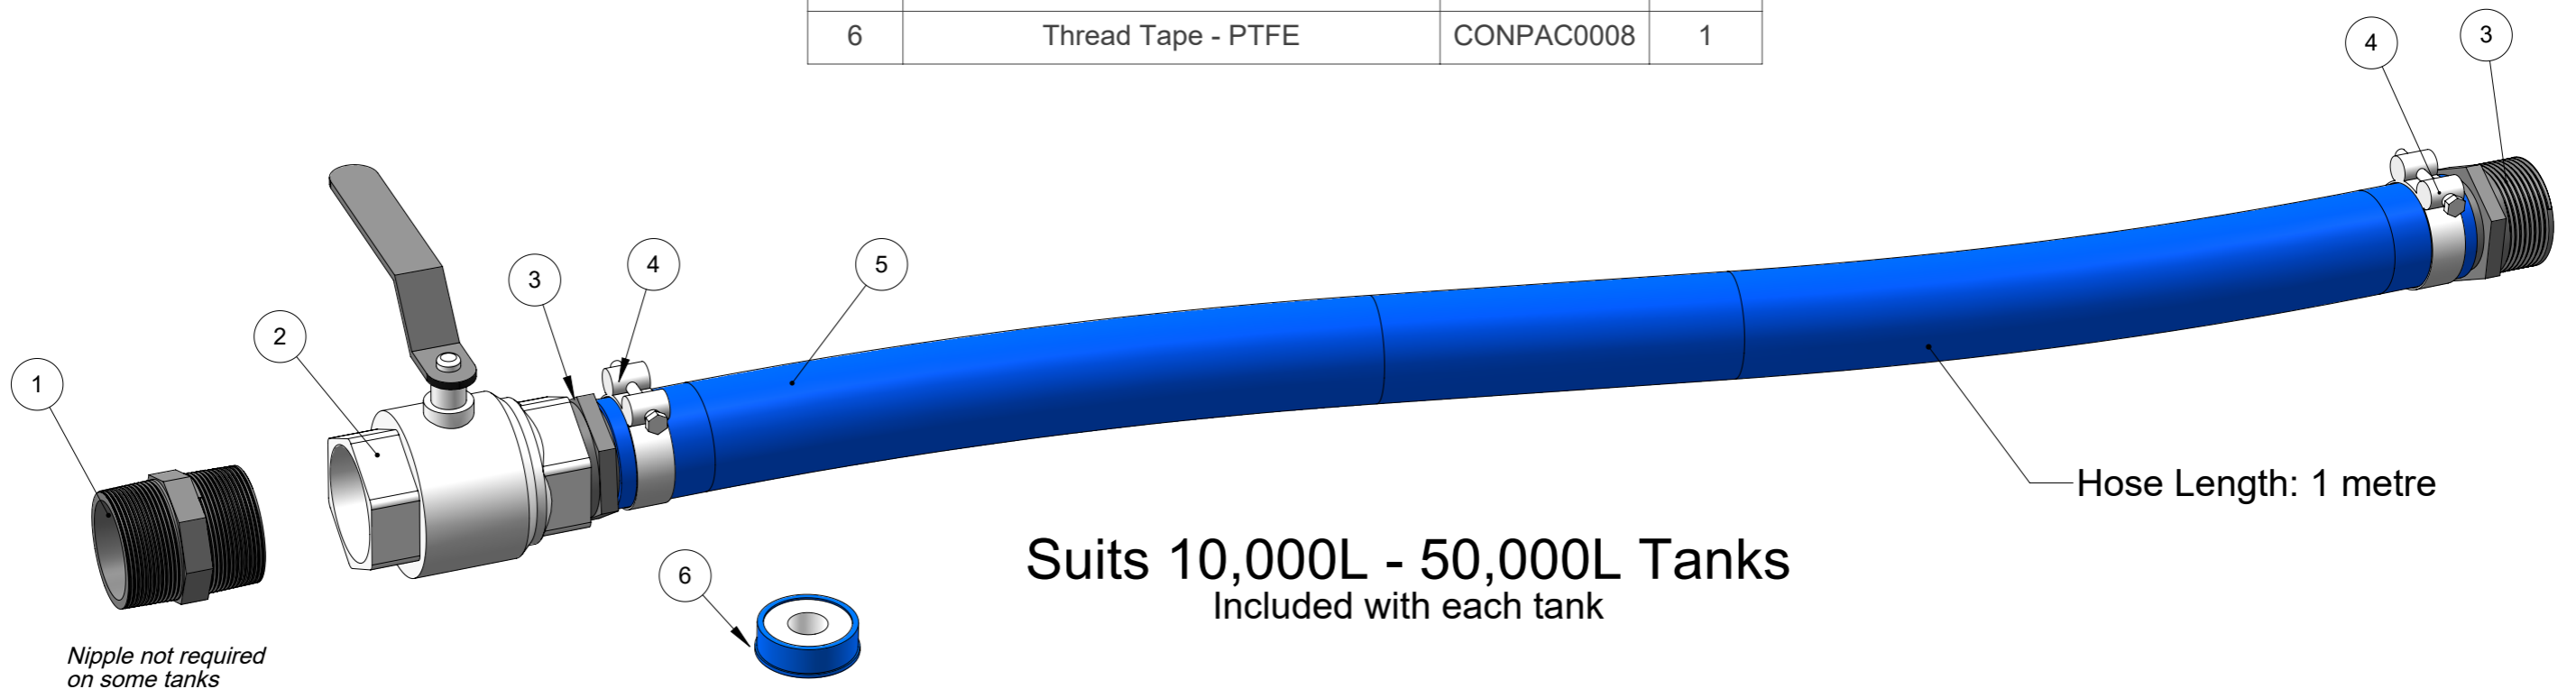

Note: Flex Connection Kit (Included with each tank) must be used on the outlet to maintain warranty. Refer Tank Installation Guidelines.

1	09.02.24	AS BUILT	DH	IG		 <p>A.C.N. 010 028 547 Gough Industries Pty. Ltd. 833 Ingham Road Bohle, Townsville P.O. Box 7570, Garbutt BC, Qld. 4814. Telephone 07 47747606 www.gough.com.au</p>	CLIENT LOGO: 50mm Flex Connection Kit	SCALE	GOUGH PLASTICS DRAWING No.	REVISION	
					NTS			A3	FTAN.204.0058	1	
					SOLDWORKS: S:\Solidworks\Rural\tanks\Connection Kits\50mm Tank Connection Kit						
					PDF. FILE PATH: S:\Products\Rural\Marketing Rural\tanks-Big						
REV	DATE	REVISION DESCRIPTION	DRAWN	CHKD.	ENG.	Dimensions are in millimetres (mm) unless noted.					